

Date: Friday, 12/12/2008 2:24:13 PM  
 User: Julie Dawson

## Process Sheet

<b>Customer</b>	: CU-DAR001 Dart Helicopters Services	<b>Drawing Name</b>	: SPRING
<b>Job Number</b>	: 44058		
<b>Estimate Number</b>	: 12285		
<b>P.O. Number</b>	:	<b>Part Number</b>	: D33355
<b>This Issue</b>	: 12/12/2008	<b>S.O. No.</b>	:
<b>Prsht Rev.</b>	: NC	<b>Drawing Number</b>	: D3335 REVC
<b>First Issue</b>	: / /	<b>Project Number</b>	: N/A
<b>Previous Run</b>	: 33948	<b>Drawing Revision</b>	: C
	<b>Type</b> : PURCHASED PARTS	<b>Material</b>	:
<b>Written By</b>	:	<b>Due Date</b>	: 22/12/2008
<b>Checked &amp; Approved By</b>	: <u>JUD 08.12.15</u>	<b>Qty:</b>	10 Um: Each
<b>Comment</b>	: Est. A 06.02.10 New issue EC		

## Additional Product

Job Number:



<b>Seq. #:</b>	<b>Machine Or Operation:</b>	<b>Description :</b>
----------------	------------------------------	----------------------

1.0	D3335	Spring
-----	-------	--------



**Comment:** Qty.: 0.5000 Each(s)/Unit Total : 5.0000 Each(s)  
 Spring B31593

SAD 09-01-14 10

2.0	SMALL FAB 1	SMALL & MEDIUM FAB RESOURCE 1
-----	-------------	-------------------------------



**Comment:** SMALL & MEDIUM FAB RESOURCE 1  
 Cut spring as per dwg D3335

SAD 09-01-14 10

3.0	QC5	INSPECT WORK TO CURRENT STEP
-----	-----	------------------------------



**Comment:** INSPECT WORK TO CURRENT STEP

508/04/14 (X10)

4.0	PACKAGING 1	PACKAGING RESOURCE #1
-----	-------------	-----------------------



**Comment:** PACKAGING RESOURCE #1  
 ID & STOCK

ST 86

88 09/01/14 (X10)

5.0	QC21	FINAL INSPECTION/W/O RELEASE
-----	------	------------------------------



**Comment:** FINAL INSPECTION/W/O RELEASE

09/01/15

Job Completion



MF 09-01-14

W/O:		WORK ORDER CHANGES					
DATE	STEP	PROCEDURE CHANGE	By	Date	Qty	Approval Chief Eng / Prod Mgr	Approval QC Inspector

Part No: \_\_\_\_\_ PAR #: \_\_\_\_\_ Fault Category: \_\_\_\_\_ NCR: Yes No DQA: \_\_\_\_\_ Date: \_\_\_\_\_

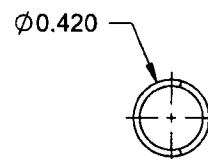
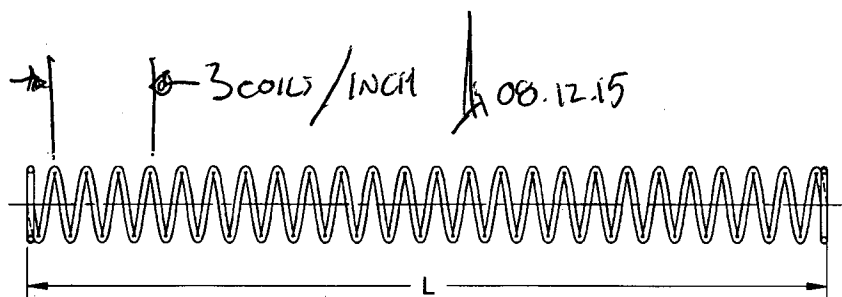
Resolution: \_\_\_\_\_ Disposition: \_\_\_\_\_ QA: N/C Closed: \_\_\_\_\_ Date: \_\_\_\_\_

NCR:		WORK ORDER NON-CONFORMANCE (NCR)						
DATE	STEP	Description of NC Section A	Corrective Action Section B			Verification Section C	Approval Chief Eng	Approval QC Inspector
			Initial Chief Eng	Action Description Chief Eng	Sign & Date			

**NOTE:** Date & initial all entries

**DART****RELEASED**  
06/03/09  
MFF

DESIGN: RF	DRAWN BY RF	<b>DART AEROSPACE LTD</b> HAWKESBURY, ONTARIO, CANADA	
CHECKED [Signature]	APPROVED [Signature]	DRAWING NO. <b>D3335</b>	REV. C SHEET 1 OF 1
DATE <b>05.12.19</b>		TITLE <b>SPRING</b>	SCALE 1:1
A	04.12.07	NEW ISSUE	
B	05.08.11	4.38 WAS 4.13; 7.63 WAS 6.80	
C	05.12.19	ADDED D3335-5, CHANGED FINISH	

**SPECIFICATION CONTROL DRAWING**

**UNDER REVIEW**  
~~03.05.05 PBA~~  
~~ADD SPRING PITCH~~

DART P/N	L (in)
D3335-1	4.38
D3335-3	7.63
D3335-5	1.20

△  
B  
△  
C

**NOTES:**

- △ C
- 1) SUPPLIER: VICTORY SPRINGS. LENGTH REQUIRED: 12".
  - 2) MATERIAL: SPRING STEEL, Ø0.035 WIRE
  - 3) FINISH: LPS PROCYON
  - 4) TOLERANCES ARE PER DART QSI 018 UNLESS OTHERWISE NOTED
  - 5) ALL DIMENSIONS ARE IN INCHES

SHOP COPY  
RETURN TO  
ENGINEERING  
UNCONTROLLED COPY  
SUBJECT TO AMENDMENT  
WITHOUT NOTICE  
WORK ORDER  
NO. 44057

**COPYRIGHT © 2004 BY DART AEROSPACE LTD.**

THIS DOCUMENT IS PRIVATE AND CONFIDENTIAL AND IS SUPPLIED ON THE EXPRESS CONDITION THAT IT IS NOT TO BE USED FOR ANY PURPOSE OR COPIED OR COMMUNICATED TO ANY OTHER PERSON WITHOUT WRITTEN PERMISSION FROM DART AEROSPACE LTD.